


AL-VI-B-230

C&P Railroad Bridge Piers (see negative file)

UNITED STATES  
DEPARTMENT OF THE INTERIOR  
GEOLOGICAL SURVEY

STATE OF  
DEPARTMENT OF GEOLOGY, M.  
JOSEPH T. SINGEW

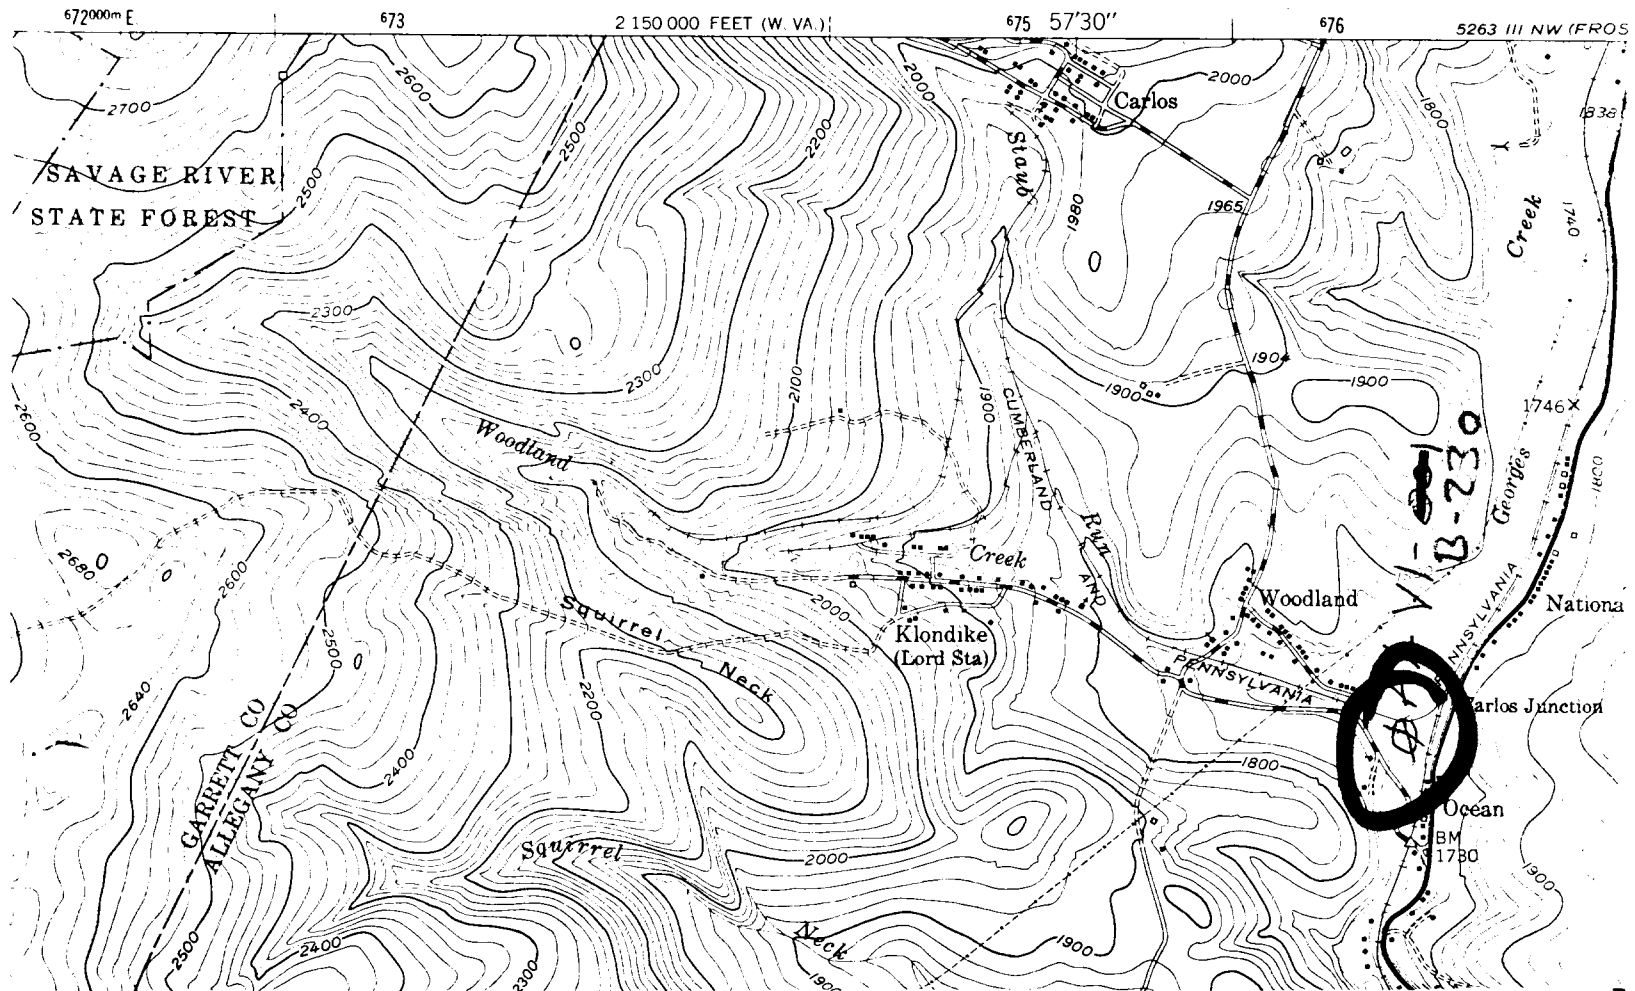

Lonaconing, MD - WV Quad  
U.S.G.S. 7.5 minute series  
1950  
scale 1:24000

AL-VI-B-230  
C&P Railroad Bridge Piers  
Site #: ~~AL-VI-001~~  
~~Miller Log House~~  
MD Route 36  
north of Midland